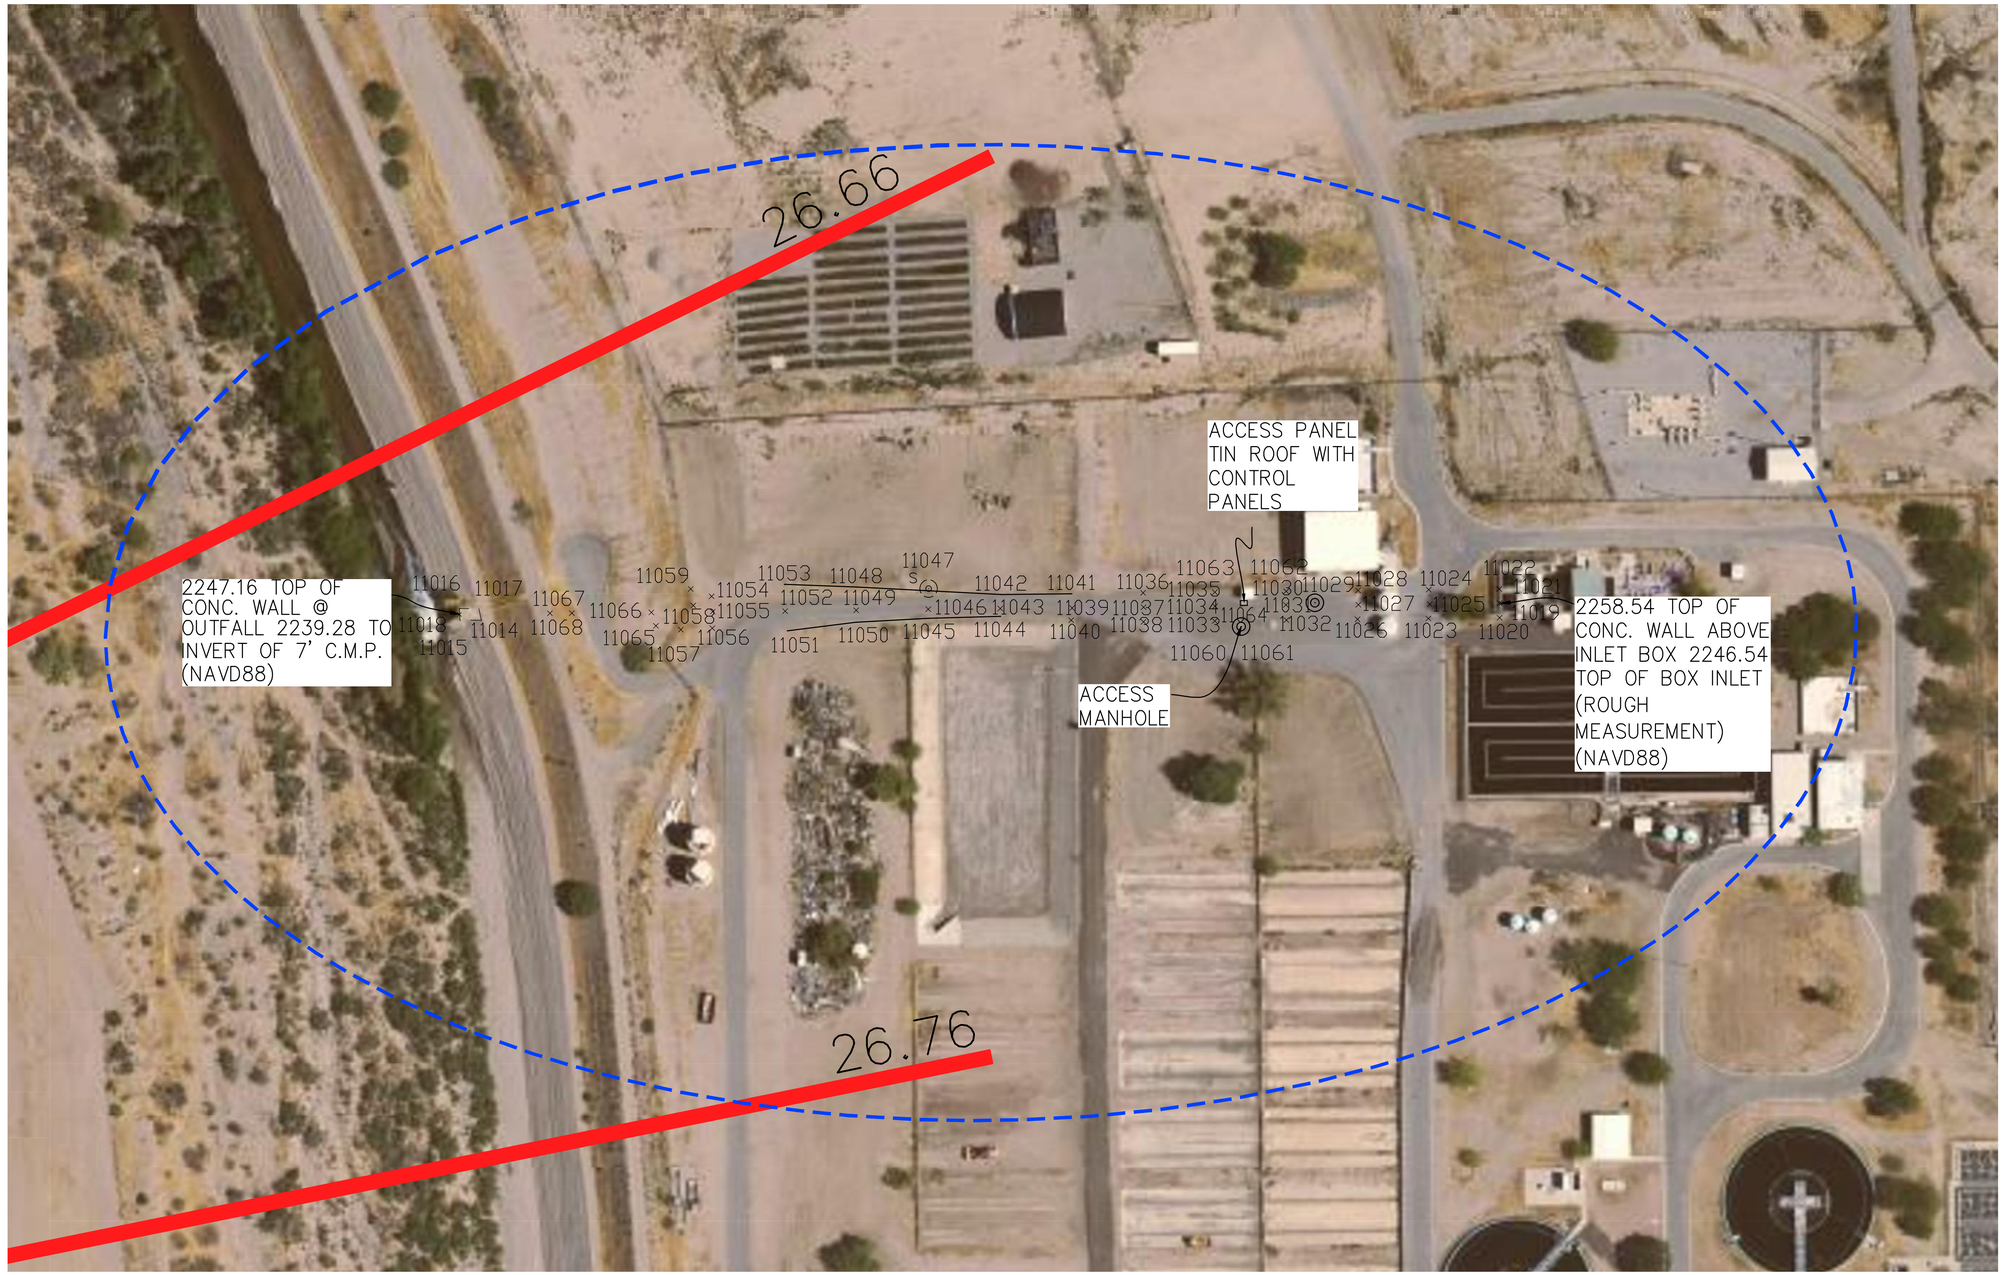

SCALE: 1" = 50'

NOTE:
POINT NUMBERS RELATE TO ELEVATIONS FOUND IN PSOMAS GROUND SURVEY (MAY 22, 2008) – APPENDIX 3

ASBUILT POINTS FOR RRWWTP ACTIVE OUTFALL

LEGEND

W.S.E.=2256.64	PSOMAS HEC-RAS WATER SURFACE ELEVATION (FT)
(W.S.E.=2256.60)	FIS HEC-2 WATER SURFACE ELEVATION (FT)
26.47	FIS CROSS SECTION
	LIMITS OF LEVEE CERTIFICATION
	WWTP TREATMENT BASIN
	REGIONAL RETENTION/ BASIN DETENTION BASIN WITH BROAD CRESTED WEIR OUTLET
	LOCAL WATERSHED WITH NO OUTLET

PSOMAS
800 E. Wetmore Road, Suite 110
Tucson, AZ 85719
(520) 292-2300 (520) 292-1290 fax
www.psomas.com

WORK MAP
FOR
ROGER ROAD WASTEWATER TREATMENT PLANT LEVEE CERTIFICATION
PSOMAS GROUND SURVEY MAY 22, 2008
FIGURE 3

PROJ NO: 08001-01 SCALE: HORIZ 1" = 50'
DATE: MAY 2008